

REV. No	DATE	BY	DESCRIPTION

Waitsburg City Hall
 Waitsburg, Washington
BASEMENT

AS-BUILD

PROFESSIONAL STAMP
(if needed)

Cdh
 NOT an Engineer
 NOT an Architect
 JUST a Draftsman
DRAFTING & CONSULTING, LLC
 4532 Lower Dry Creek Road
 Pullman, WA 99163
 PHONE: (509) 325-3389 FAX: (509) 325-4711
 Serving the Wenatchee Valley since 2004


AREA CALCULATION

BASEMENT:	2,102 SQUARE FEET
GROUND LEVEL:	2,102 SQUARE FEET
MEZZ LEVEL:	643 SQUARE FEET
2ND FLOOR:	2,102 SQUARE FEET
GRAND TOTAL:	6,949 SQUARE FEET



1H **BASEMENT** 22x34 = SCALE: 3/8"=1'-0"
 11x17 = SCALE: 3/16"=1'-0"

PROJECT NUMBER: 18016	DRAWING NUMBER 18016-1	REV 1
DRAWN BY: cdh	DATE: April 2018	BY ab

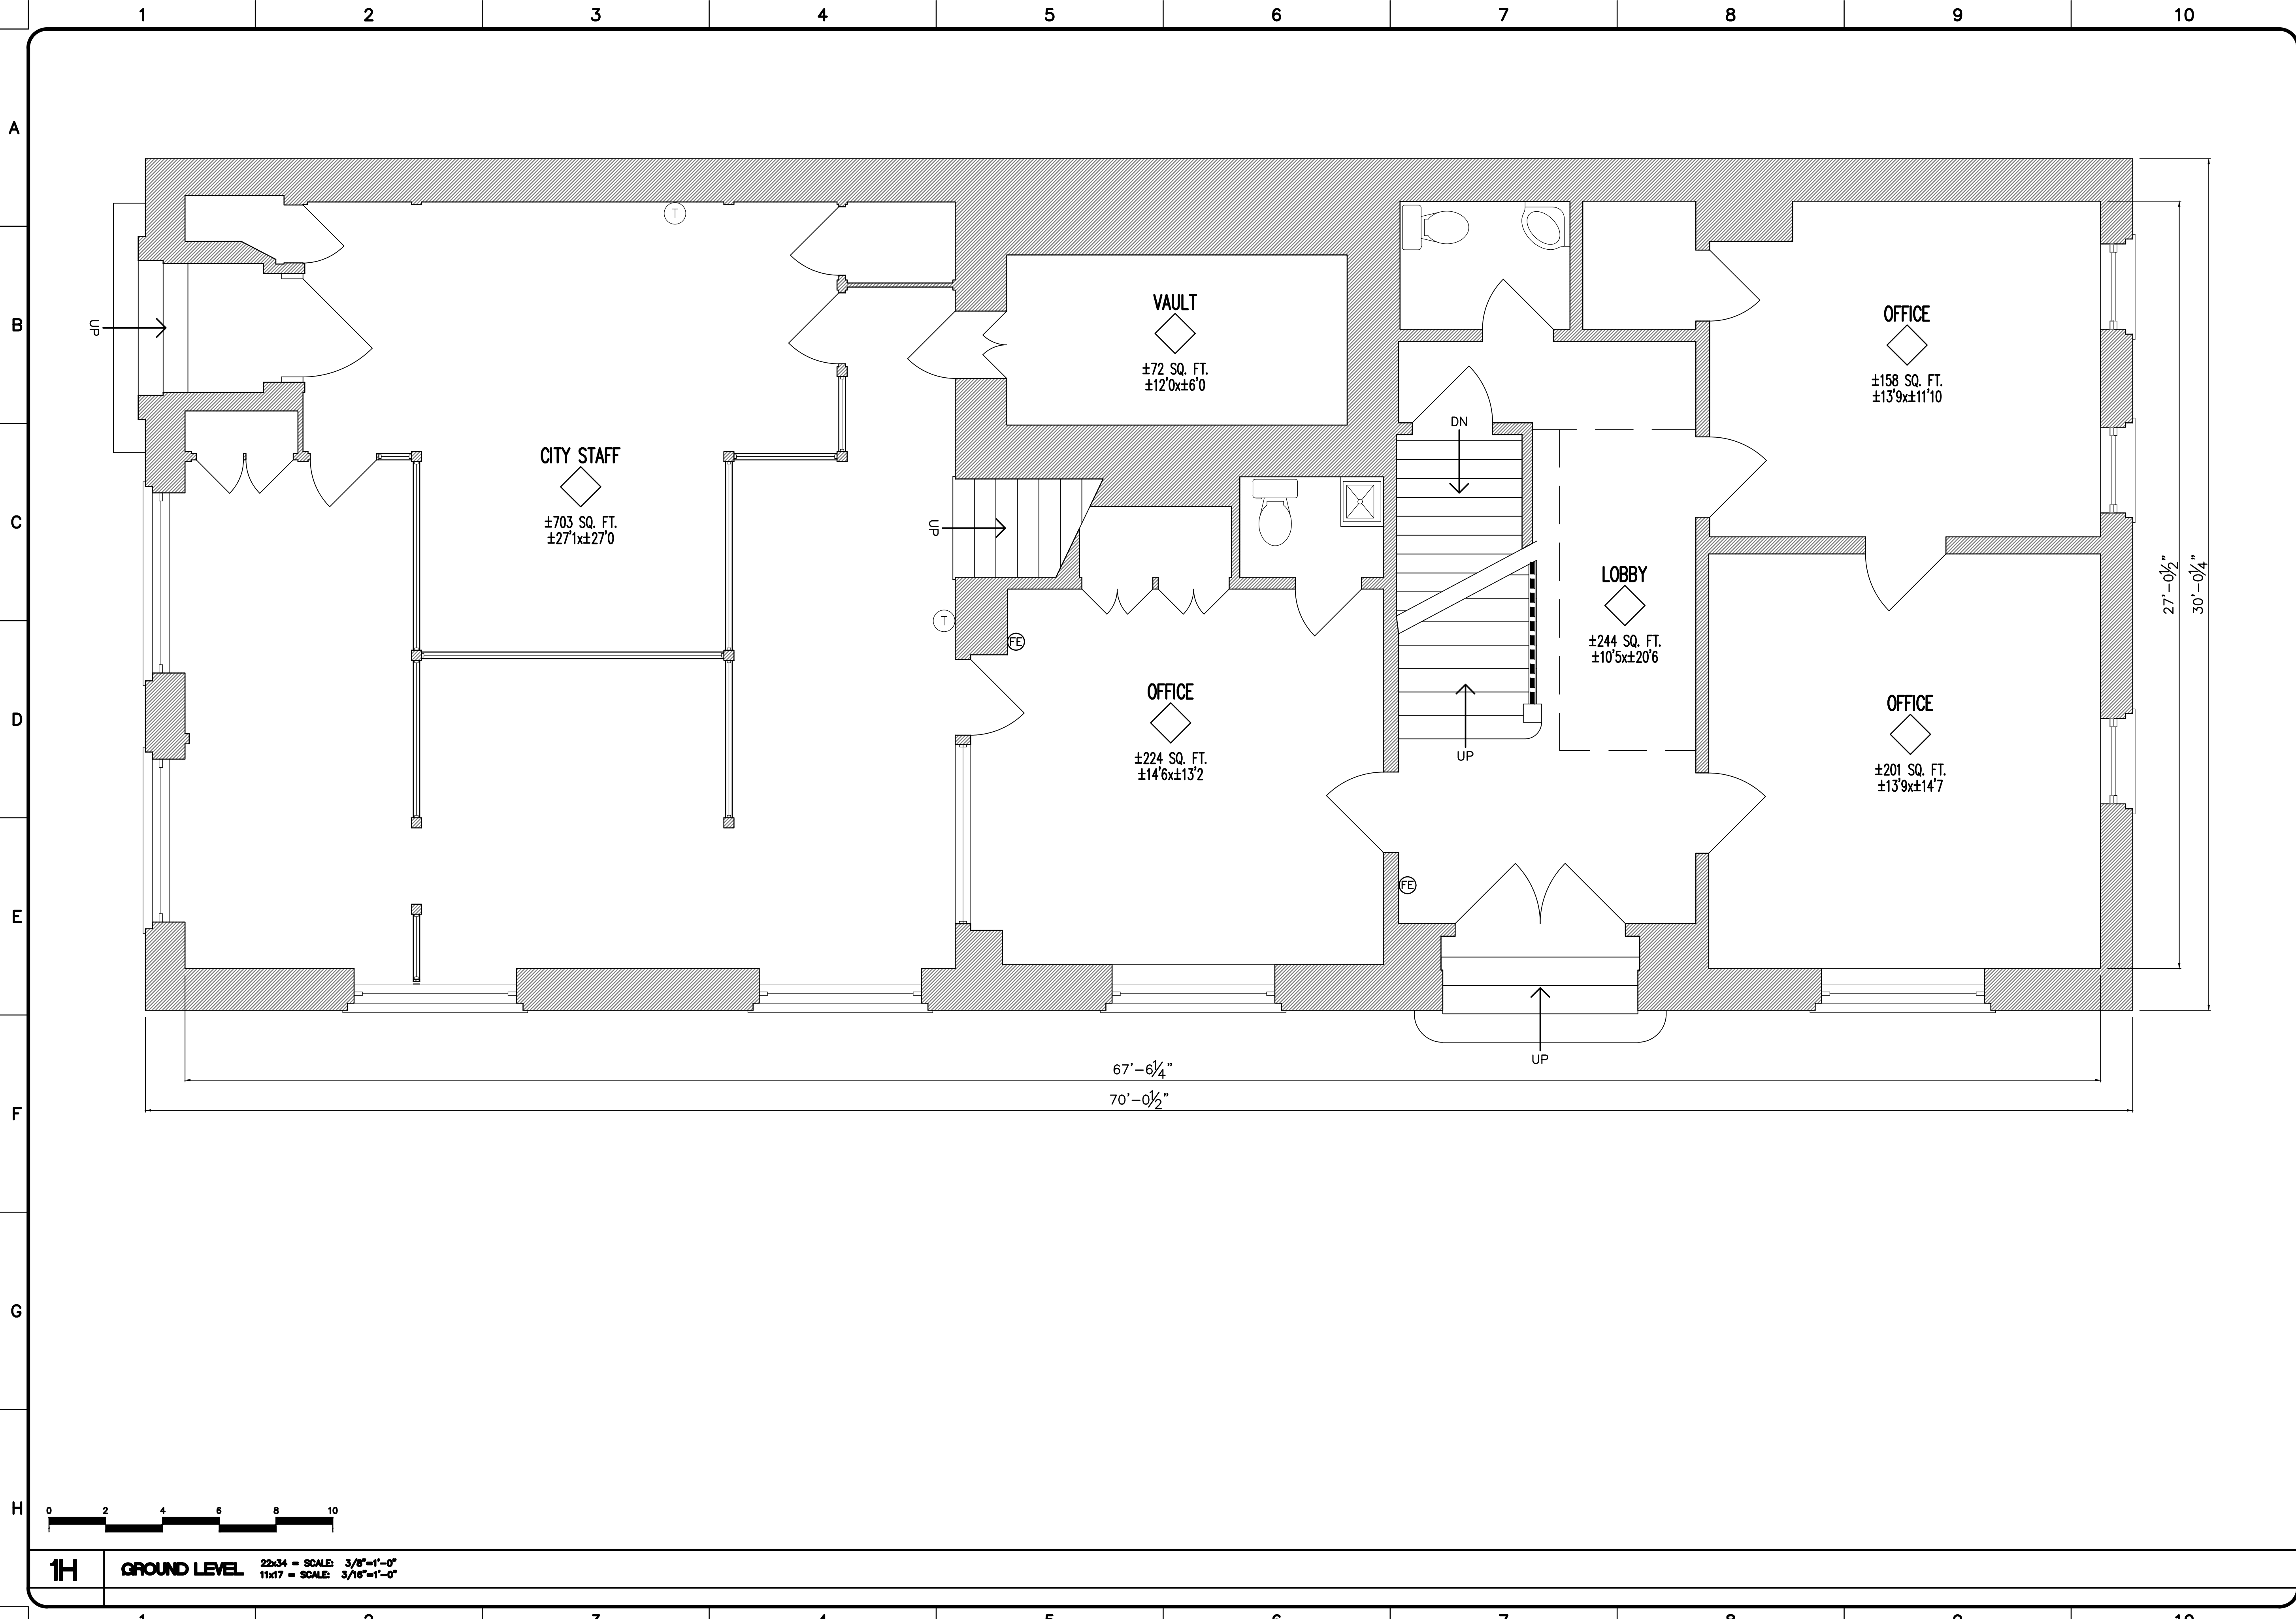

REV. No	DATE	BY	DESCRIPTION

Waitsburg City Hall
Waitsburg, Washington

1st FLOOR


AS-BUILD

PROFESSIONAL STAMP
(if needed)

Cdh
NOT an Engineer
NOT an Architect
JUST a Draftsman
DRAFTING & CONSULTING, LLC
4532 Lower Dry Creek Road
Walla Walla, Washington
PHONE: (509) 325-3389 FAX: (509) 328-4711
Serving the Walla Walla Valley since 2004

PROJECT NUMBER: 18016	DRAWING NUMBER: 18016-2	REV: 2
CAD FILE: 18016-2	DATE: April 2018	BY: ab

1H **GROUND LEVEL**

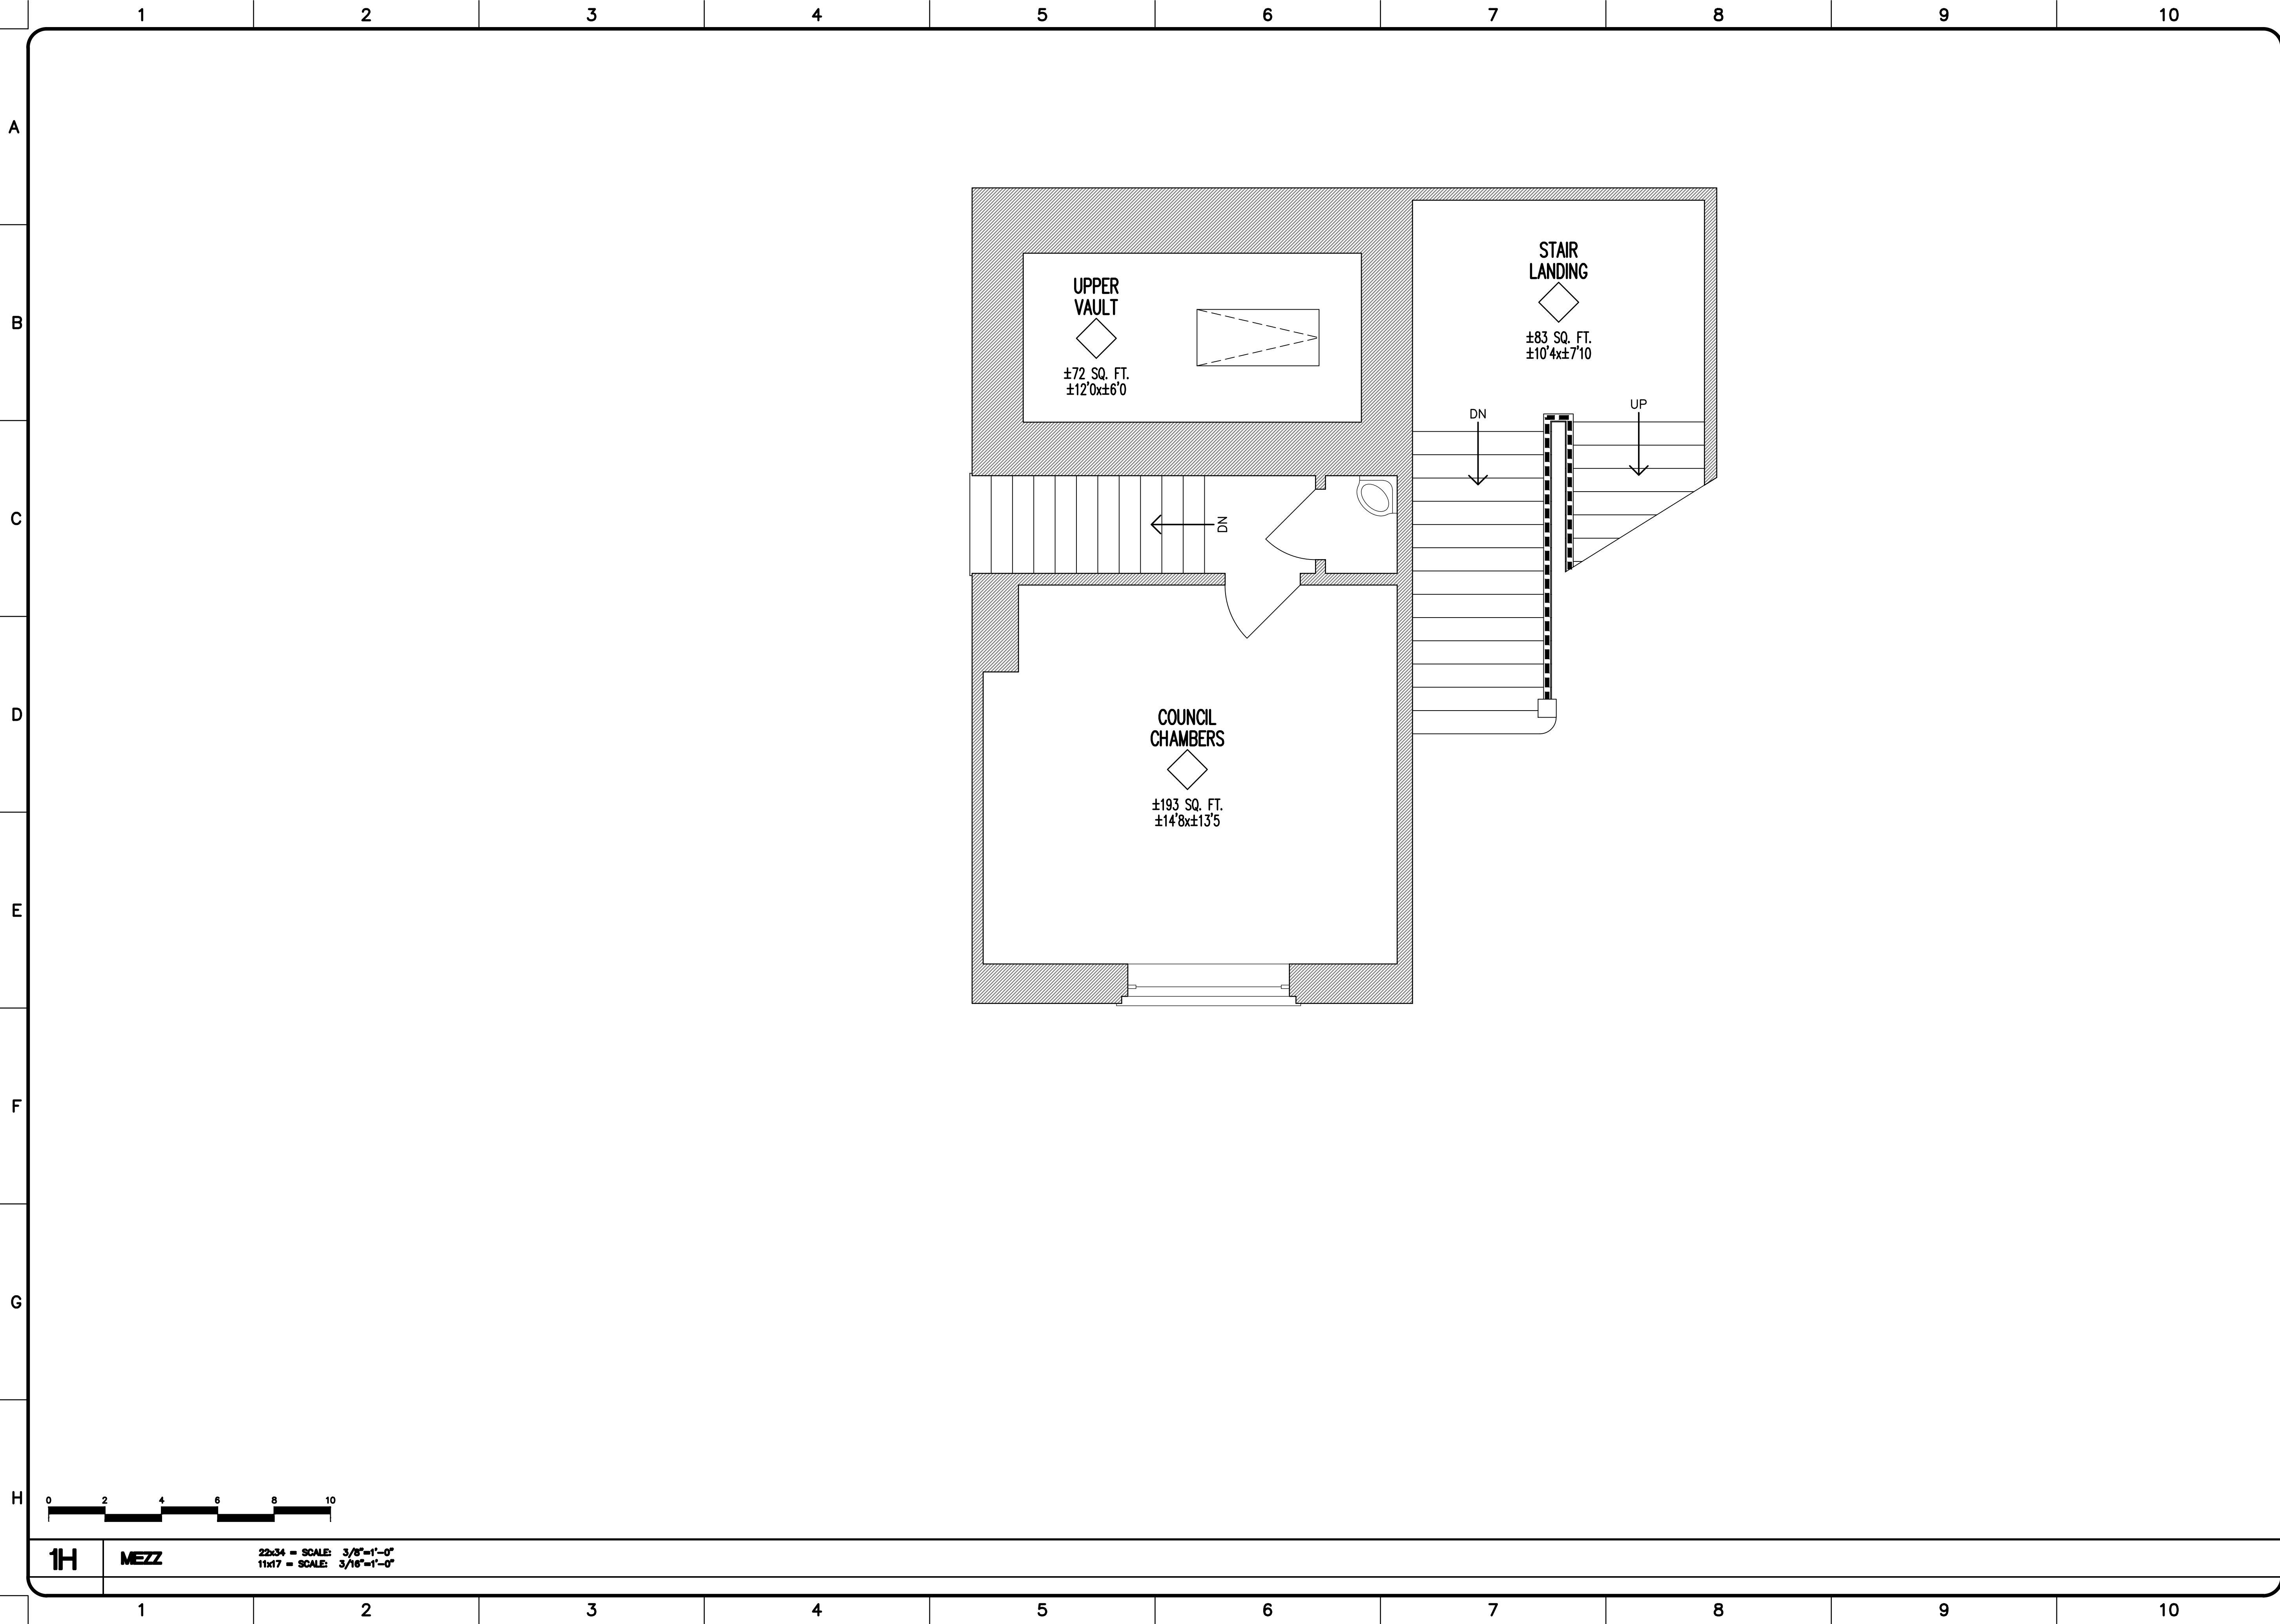

1H **MEZZ** 22x34 = SCALE: 3/8"=1'-0"
 11x17 = SCALE: 3/16"=1'-0"

REV. No	DATE	BY	DESCRIPTION


Waitsburg City Hall
Waitsburg, Washington
MEZZ LEVEL

AS-BUILD

PROFESSIONAL STAMP
 (if needed)

Cdh
 NOT an Engineer
 NOT an Architect
 JUST a Draftsman
DRAFTING & CONSULTING, LLC
 4532 Lower Dry Creek Road Main Walk, Washington
 PHONE: (509) 325-3389 CELL: (509) 328-4711
 Serving the Main Walk Valley since 2004

PROJECT NUMBER: 18016	DRAWING NUMBER	REV
CAD FILE: 18016-3	3	ab
DRAWN BY: cdh	DATE: April 2018	

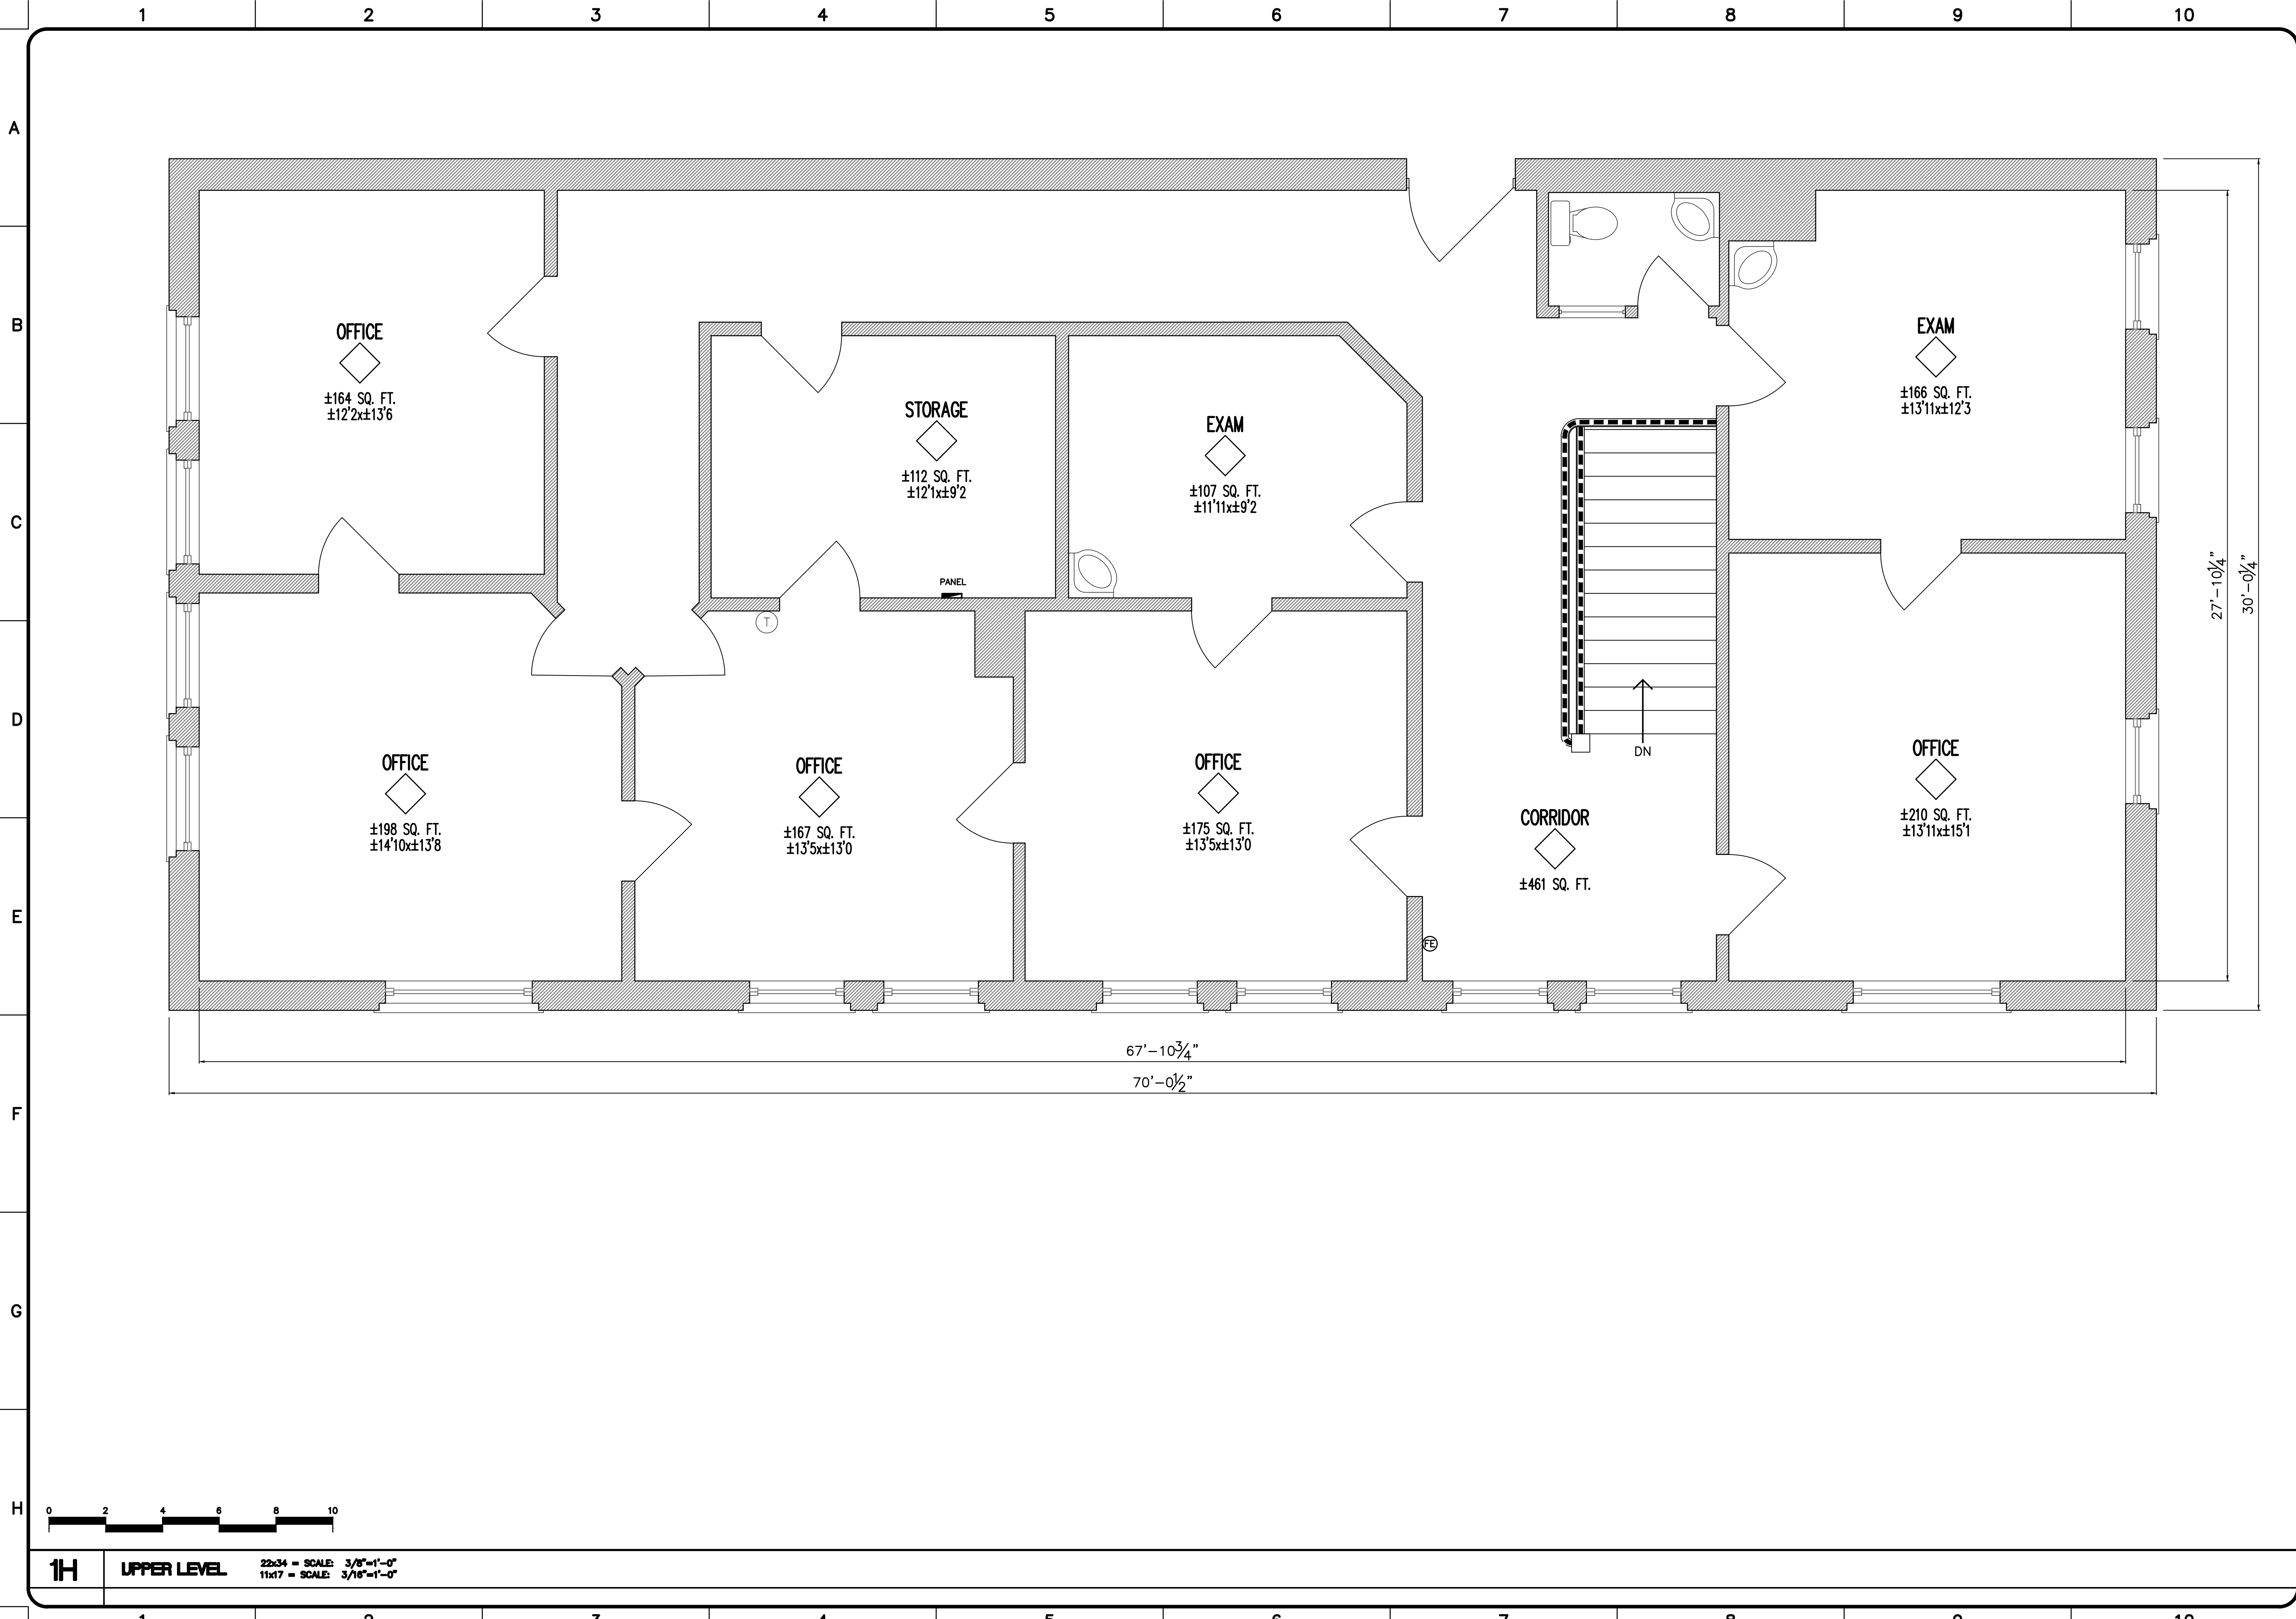

1H UPPER LEVEL 22x34 = SCALE: 3/8"=1'-0"
11x17 = SCALE: 3/16"=1'-0"

REV. No	DATE	BY	DESCRIPTION

Waitsburg City Hall
Waitsburg, Washington


UPPER LEVEL

AS-BUILD

PROFESSIONAL STAMP
(if needed)

Cdh
NOT an Engineer
NOT an Architect
JUST a Draftsman
DRAFTING & CONSULTING, LLC
432 Lower Dry Creek Road
Phone: (509) 325-3389
GALLI, (509) 328-4711
Serving the Walla Walla Valley since 2004.

PROJECT NUMBER: 18016	DRAWING NUMBER 4	REV ab
CAD FILE: 18016-4	DATE: April 2018	cdh

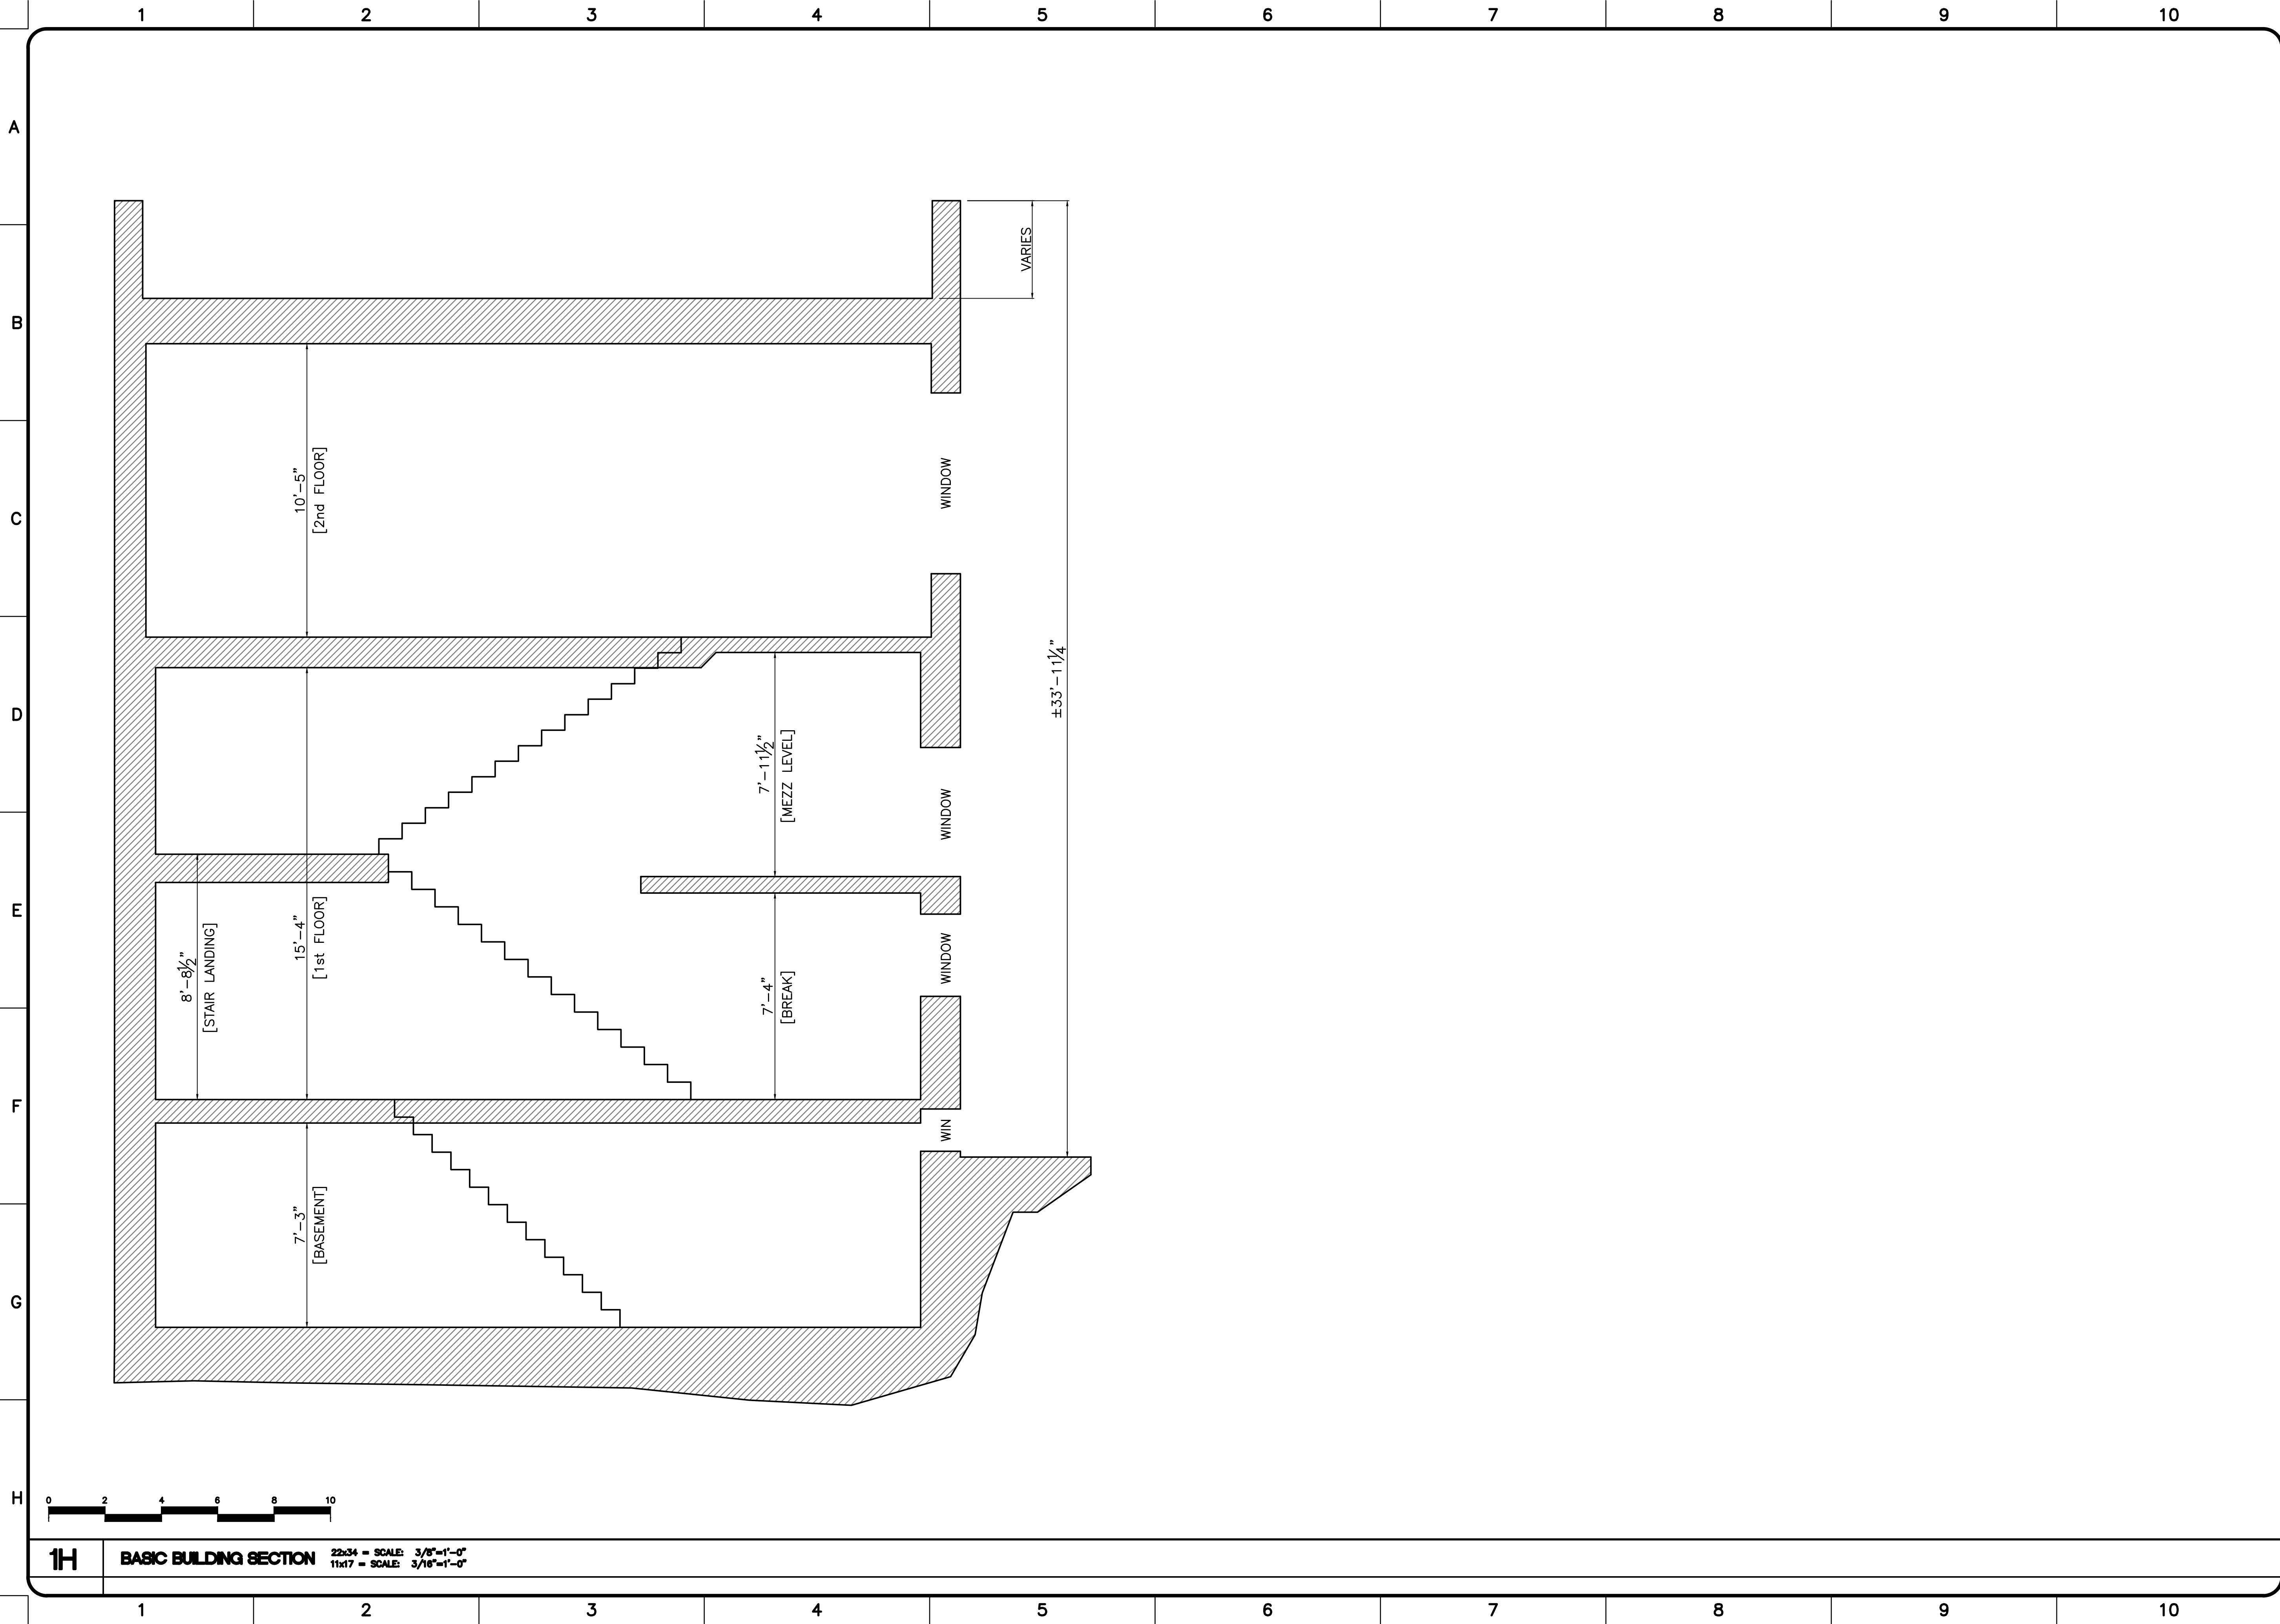

1H BASIC BUILDING SECTION 22x34 = SCALE: 3/8"=1'-0"
 11x17 = SCALE: 3/16"=1'-0"

REV No	DATE	BY	DESCRIPTION

Waitsburg City Hall
 Waitsburg, Washington

BASIC SECTION

AS-BUILD

PROFESSIONAL STAMP
 (if needed)

Cdh
 NOT an Engineer
 NOT an Architect
 JUST a Draftsman
DRAFTING & CONSULTING, LLC
 4532 Lower Dry Creek Road
 Phone: (509) 325-3389
 Fax: (509) 325-4711
 Serving the Walla Walla Valley since 2004

PROJECT NUMBER: **18016**
 CAD FILE: **18016-5**

DRAWING NUMBER: **5**
 REV: **ab**

DRAWN BY: **cdh**
 DATE: April 2018

APPROVED	DESCRIPTION	BY	DATE